

AS BUILT NOTES:


- 1) ALL WATER SERVICES ARE PERPENDICULAR TO THE WATER MAIN.
- 2) TEST FROM SEWER SERVICE PIPES TO MANHOLES TAKEN FROM GROUND NOTES PROVIDED BY GAS WISCONSIN DEPT.
- 3) PROPOSED LINES SHOWN ARE INFORMATIONAL ONLY. THE WHERE PROPER FOR THE PROJECT. PRIMARY PLAN BY SOUTH LEINA SUBDIVISION BY R.H.M. ENGINEERING.



AS BUILT


SHEET NO. 17
of 42
PLAN AND PROFILE
STA "0" 53+80 TO STA "0" 60+50

LEINA ACCESS ROAD
CONTRACT NO. E02-210

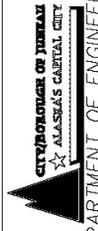


DATE	REVISIONS	BY

WE HEREBY CERTIFY THAT THE AS-BUILT REPRESENTS SURVEY HEREON WERE MADE BY MYSELF OR UNDER MY DIRECTION, AND ARE CORRECT. PROJECT COMPLETED - 7/03

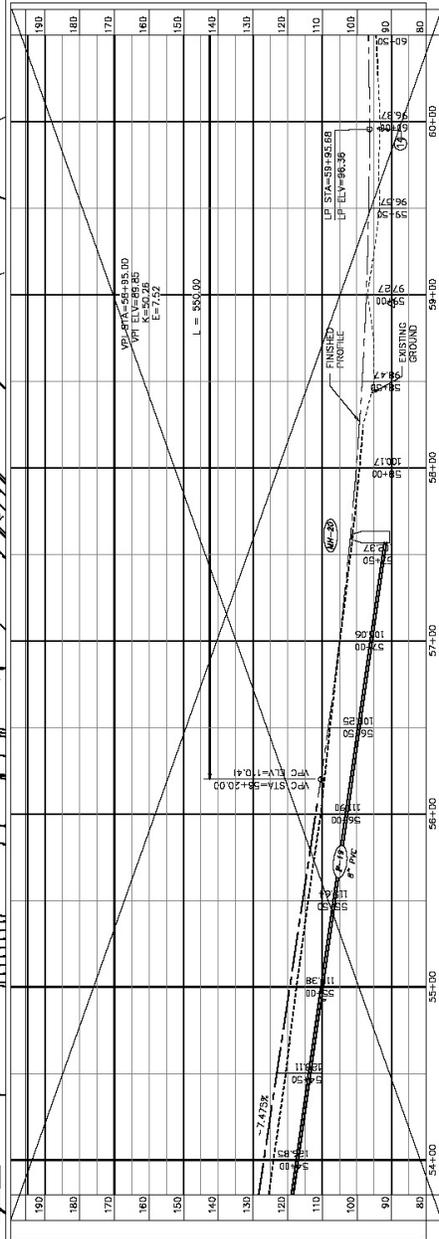



DATE	REVISIONS	BY

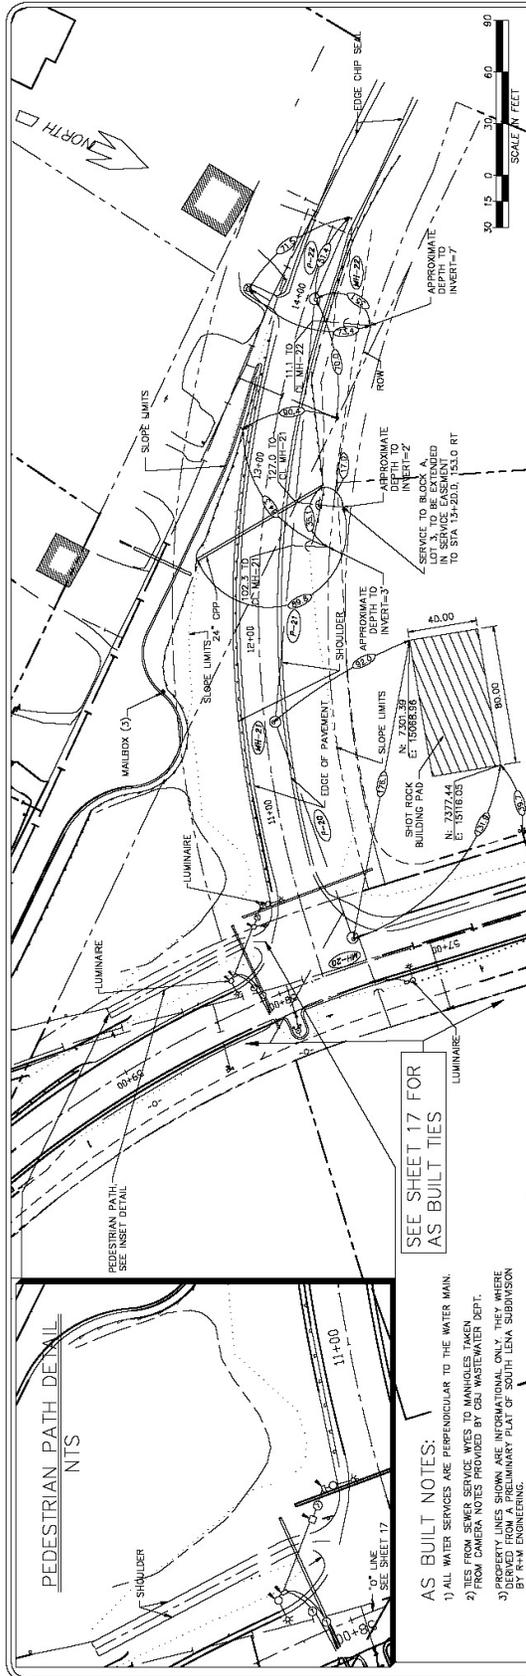

SEE SHEET 17 FOR AS BUILT TIES

AS BUILT NOTES:

- 1) ALL WATER SERVICES ARE PERPENDICULAR TO THE WATER MAIN.
- 2) TIES FROM SEWER SERVICE LINES TO MANHOLES TAKEN FROM CAMERA NOTES PROVIDED BY CBU WASTEWATER DEPT.
- 3) PROPERTY LINES SHOWN ARE INFORMATIONAL ONLY. THEY WERE OBTAINED FROM THE SURVEY AND SUMMARY PLAN OF SOUTH LENA SUBDIVISION BY RVM ENGINEERS.

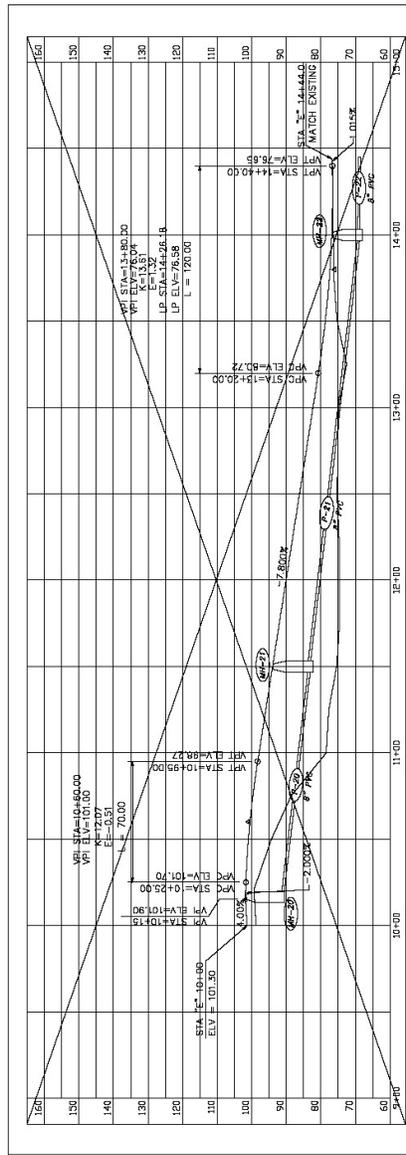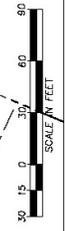

AS BUILT
 INTERSECTION DETAIL
 PT. LENA LOOP (EAST) CONNECTION
 STA "E" 10+00 TO STA "E" 14+44



Lozier Nording
 & ASSOCIATES, INC.
 ENGINEERS

1910
 1000
 1000

WE HEREBY CERTIFY THAT THE AS-BUILT MEASUREMENTS SHOWN HEREON WERE MADE BY MYSELF OR UNDER MY DIRECTION, AND ARE CORRECT.
 PROJECT COMPLETED - 7/03

DATE	REVISIONS	BY

