


Parcel #19 Acreage: 42,167 square feet
Legal Description: Lot 3, Block A, South Lena Subdivision

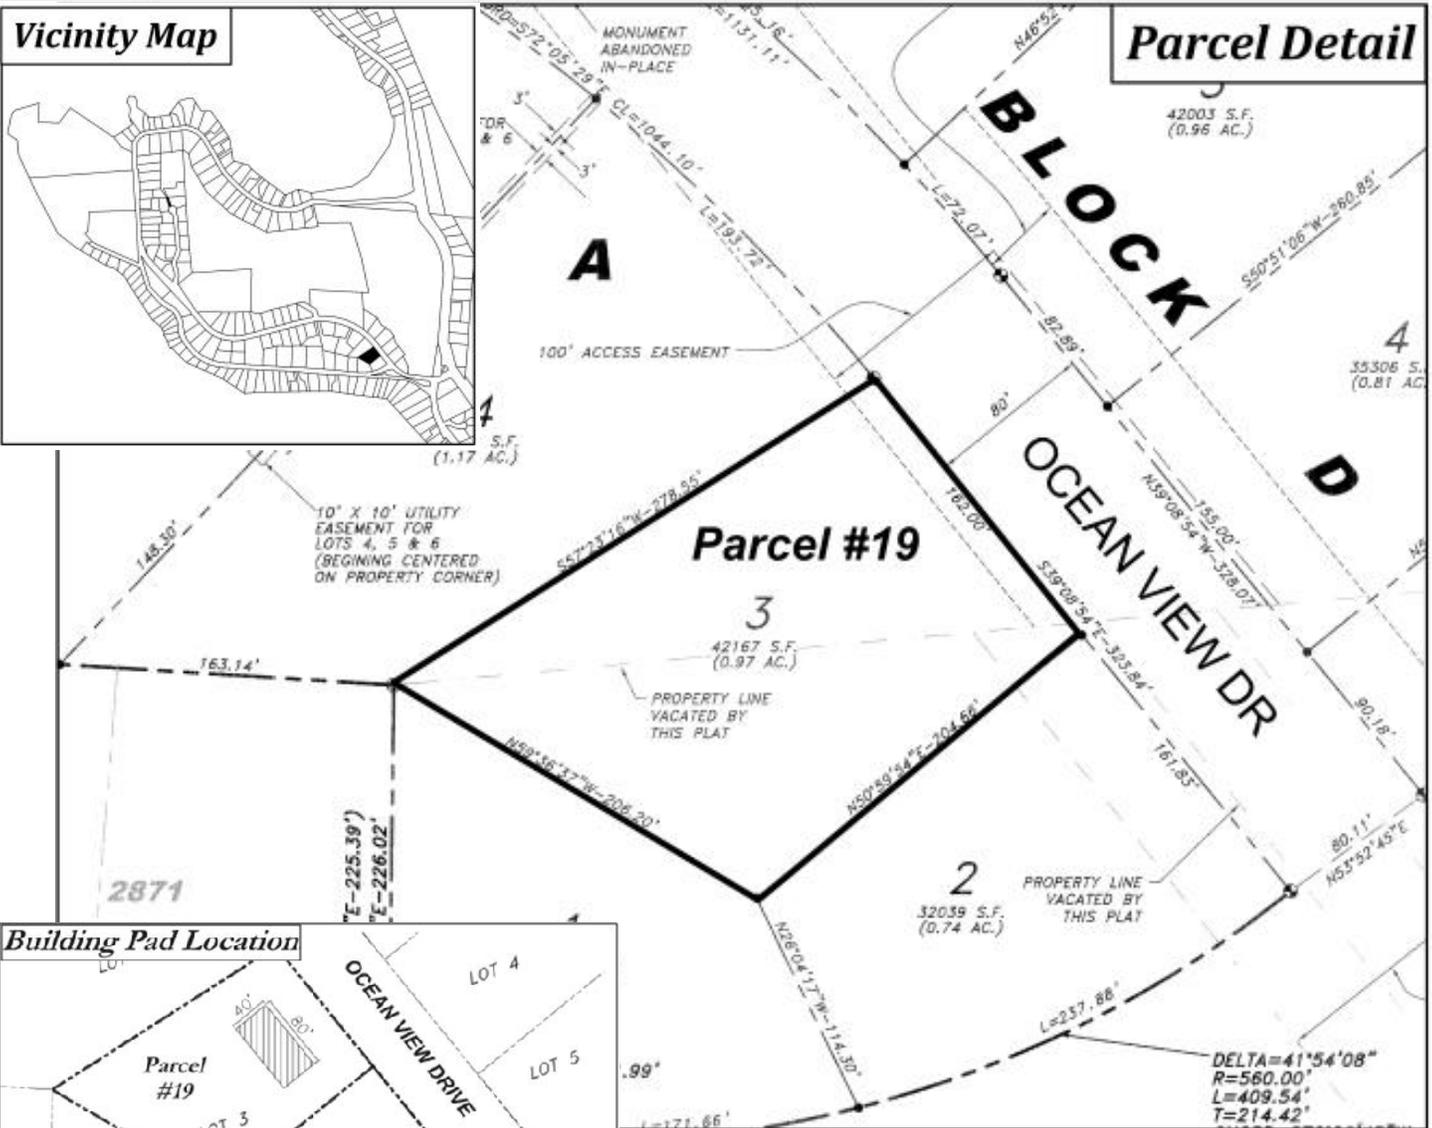

Minimum Bid: \$107,000

Wetlands: No wetlands have been identified on the lot.

Special Conditions: Special conditions A, I and J apply to this lot. See page 6 and 7 for descriptions of those conditions.

The building pad location drawing depicts the general location and orientation of the proposed building pad on this lot. The drawing is not a survey. It is intended for general reference purposes only. See page 11 for an as-built survey. Bidders interested in this parcel are encouraged to examine this property closely to determine whether the property meets their development goals.

As-Built Drawing for Parcel #19

(Lot 3, Block A)

